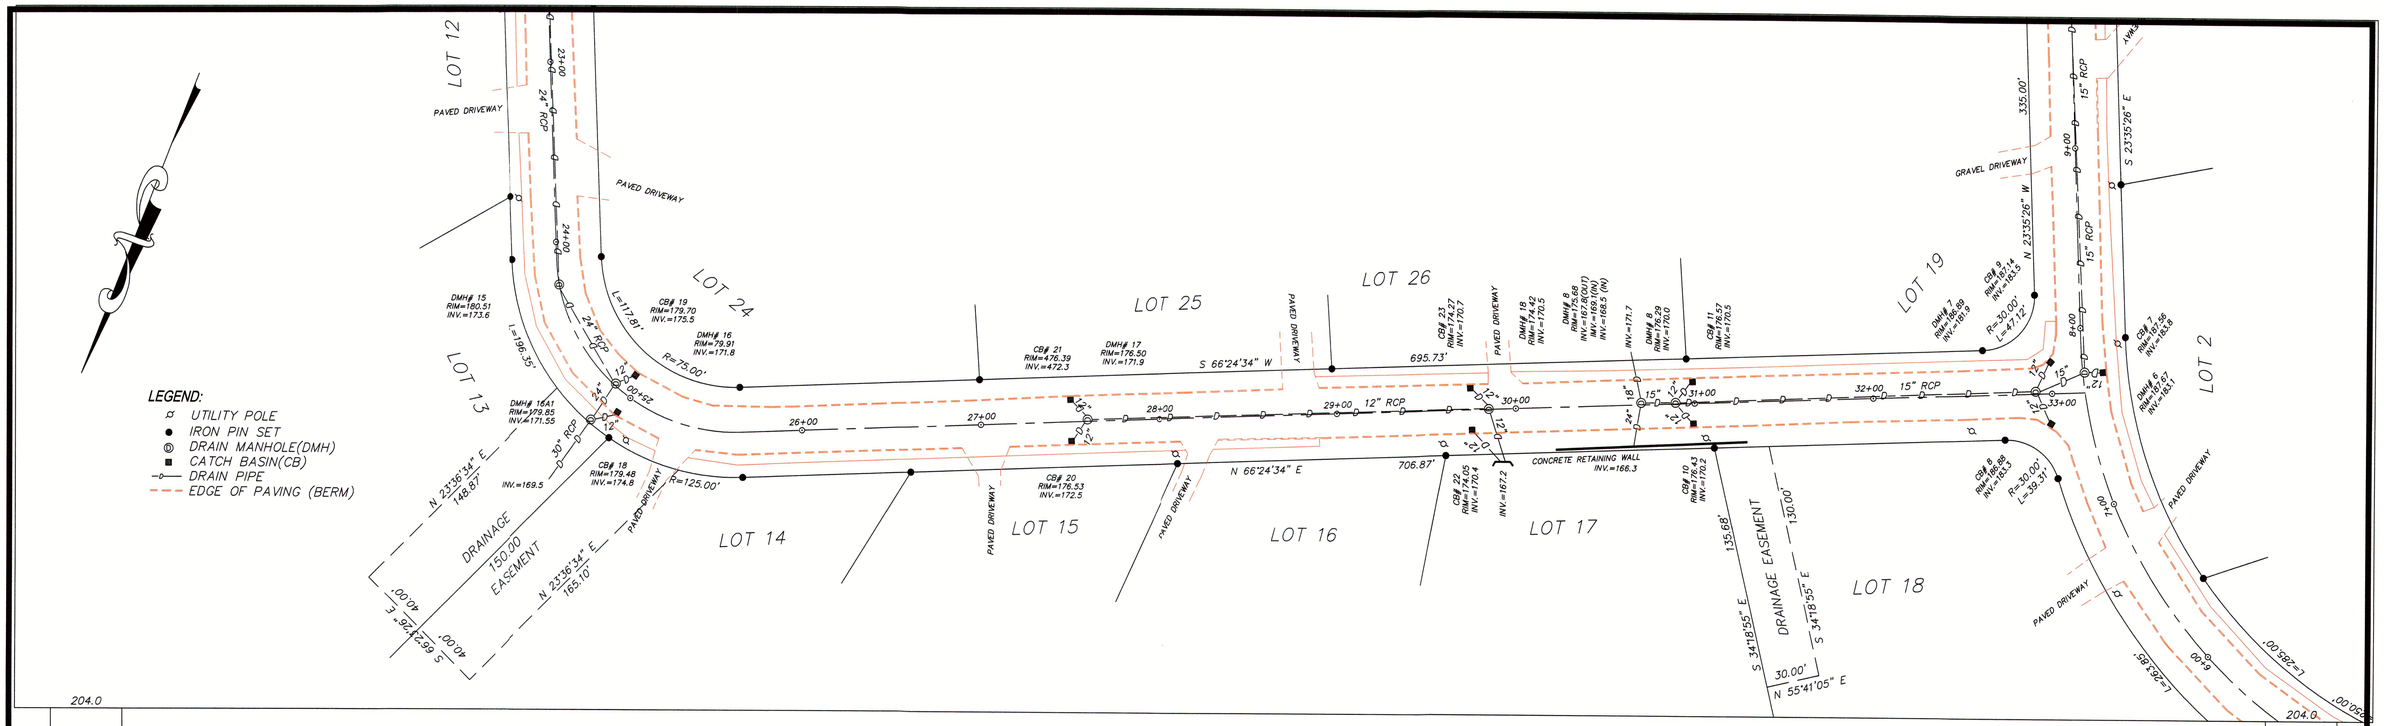


GRAPHIC SCALE

40 0 20 40 80 160


(IN FEET)
1 inch = 40 ft.

PLAN SCALE:	1"=40'	REVISIONS:			
DATUM:	ASSUMED	No.	Date:	No.	Date:
DRAWN BY:	EJB	1	8-30-04	5	
CALCULATIONS BY:	EJB	2		6	
DRAWN BY:	EJB	3		7	
DATE:	JULY 10, 2004	4		8	

EDMOND J. BOUCHER, PLS
REGISTERED LAND SURVEYOR
4 JOLLY ROAD, ROYALSTON, MA 01368
TEL. (978) 249-6685 FAX (978) 249-4517

COMMONWEALTH OF MASSACHUSETTS
EDMOND J. BOUCHER No. 34300 REGISTERED LAND SURVEYOR


AS-BUILT PLAN
OF
LAUREL VIEW
IN
TEMPLETON, MA

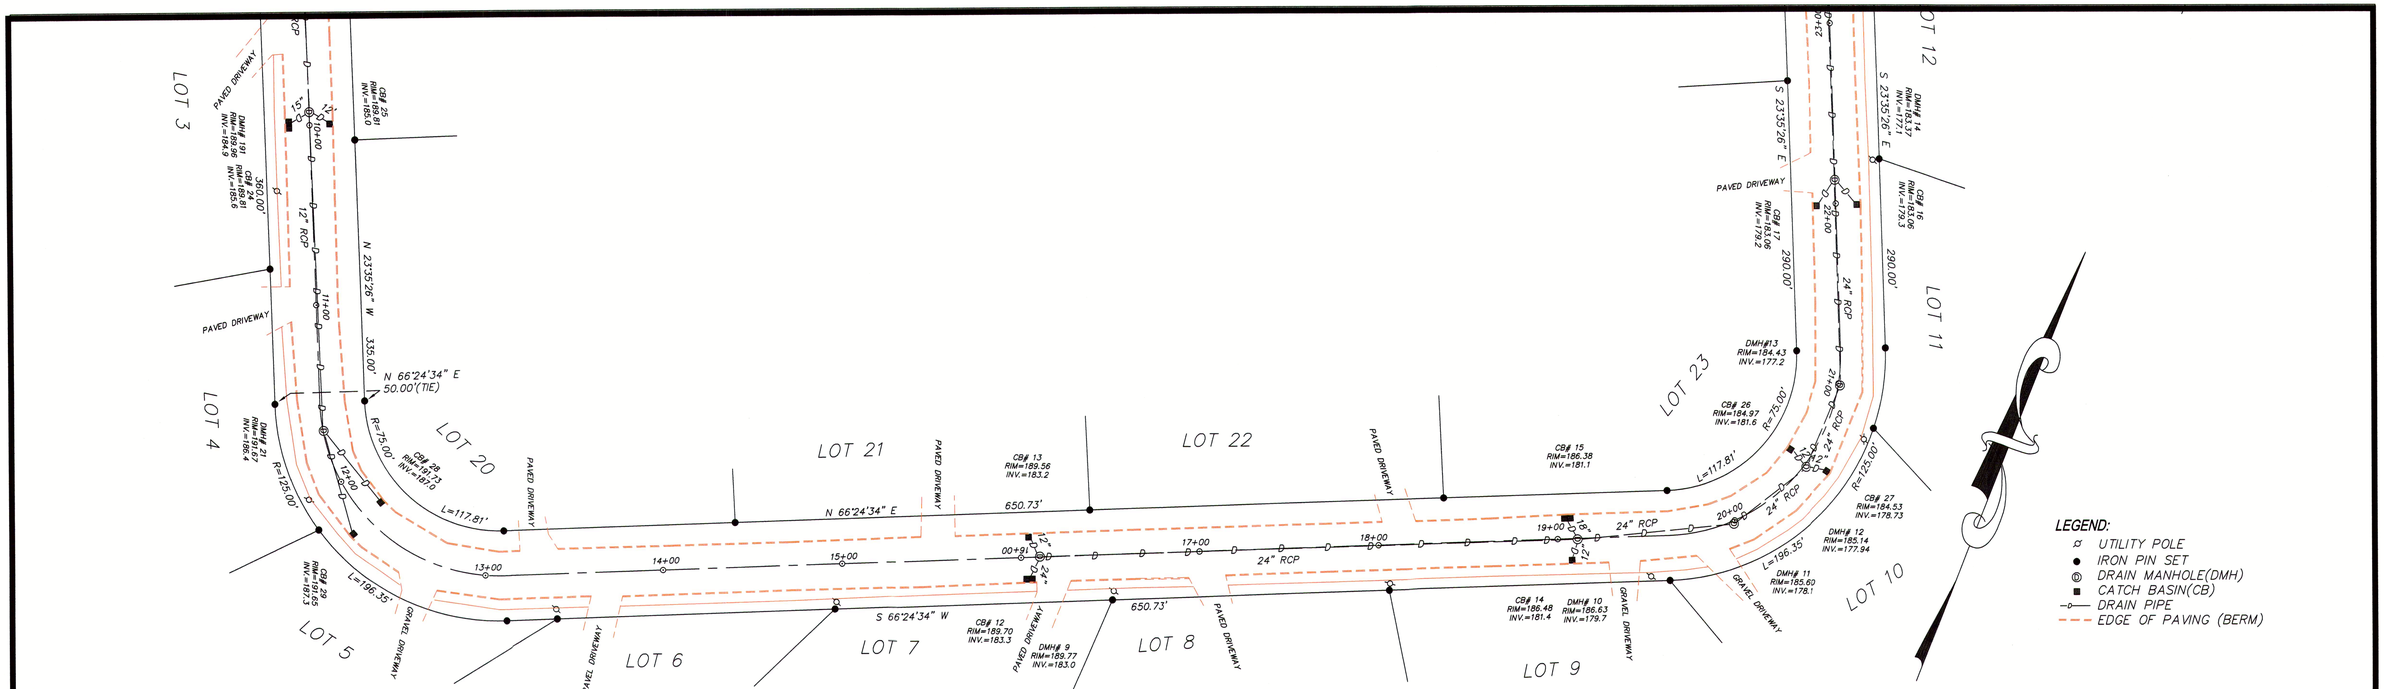

GRAPHIC SCALE

40 0 20 40 80 160

(IN FEET)
1 inch = 40 ft.

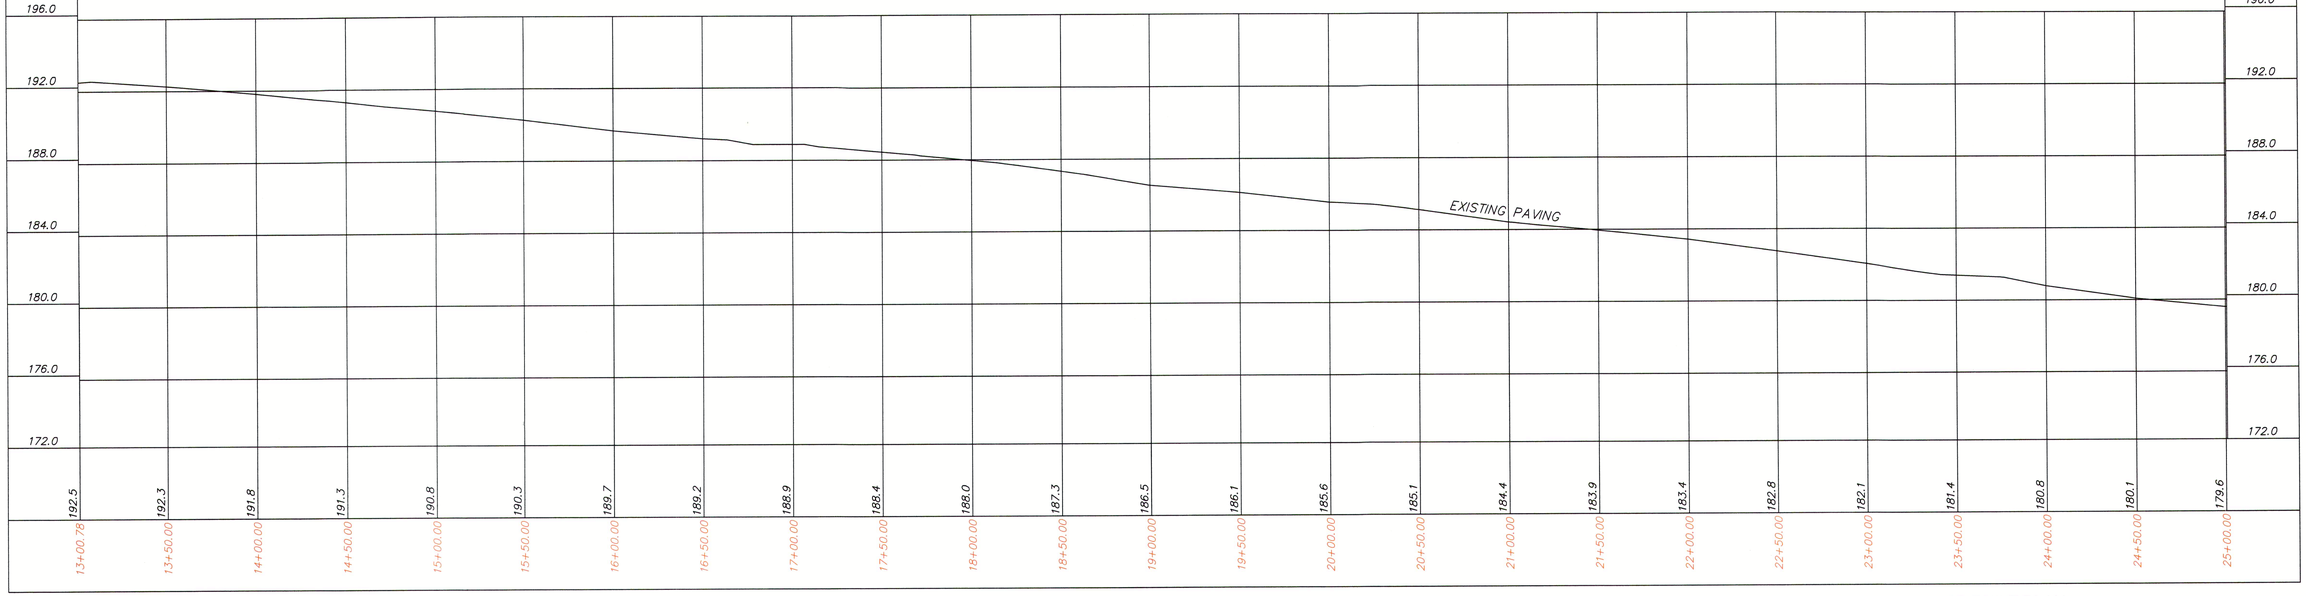


PLAN SCALE:	1"=40'	REVISIONS:			
DATUM:	ASSUMED	No.	Date:	No.	Dcte:
DRAWN BY:	EJB	1	8-30-04	5	
CALCULATIONS BY:	EJB	2		6	
DRAWN BY:	EJB	3		7	
DATE:	JULY 10, 2004	4		8	

EDMOND J. BOUCHER, PLS
REGISTERED LAND SURVEYOR
4 JOLLY ROAD, ROYALSTON, MA 01368
TEL. (978) 249-6685 FAX (978) 249-4517

COMMONWEALTH OF MASSACHUSETTS
EDMOND J. BOUCHER
No. 34300
REGISTERED LAND SURVEYOR


AS-BUILT PLAN
OF
LAUREL VIEW
IN
TEMPLETON, MA

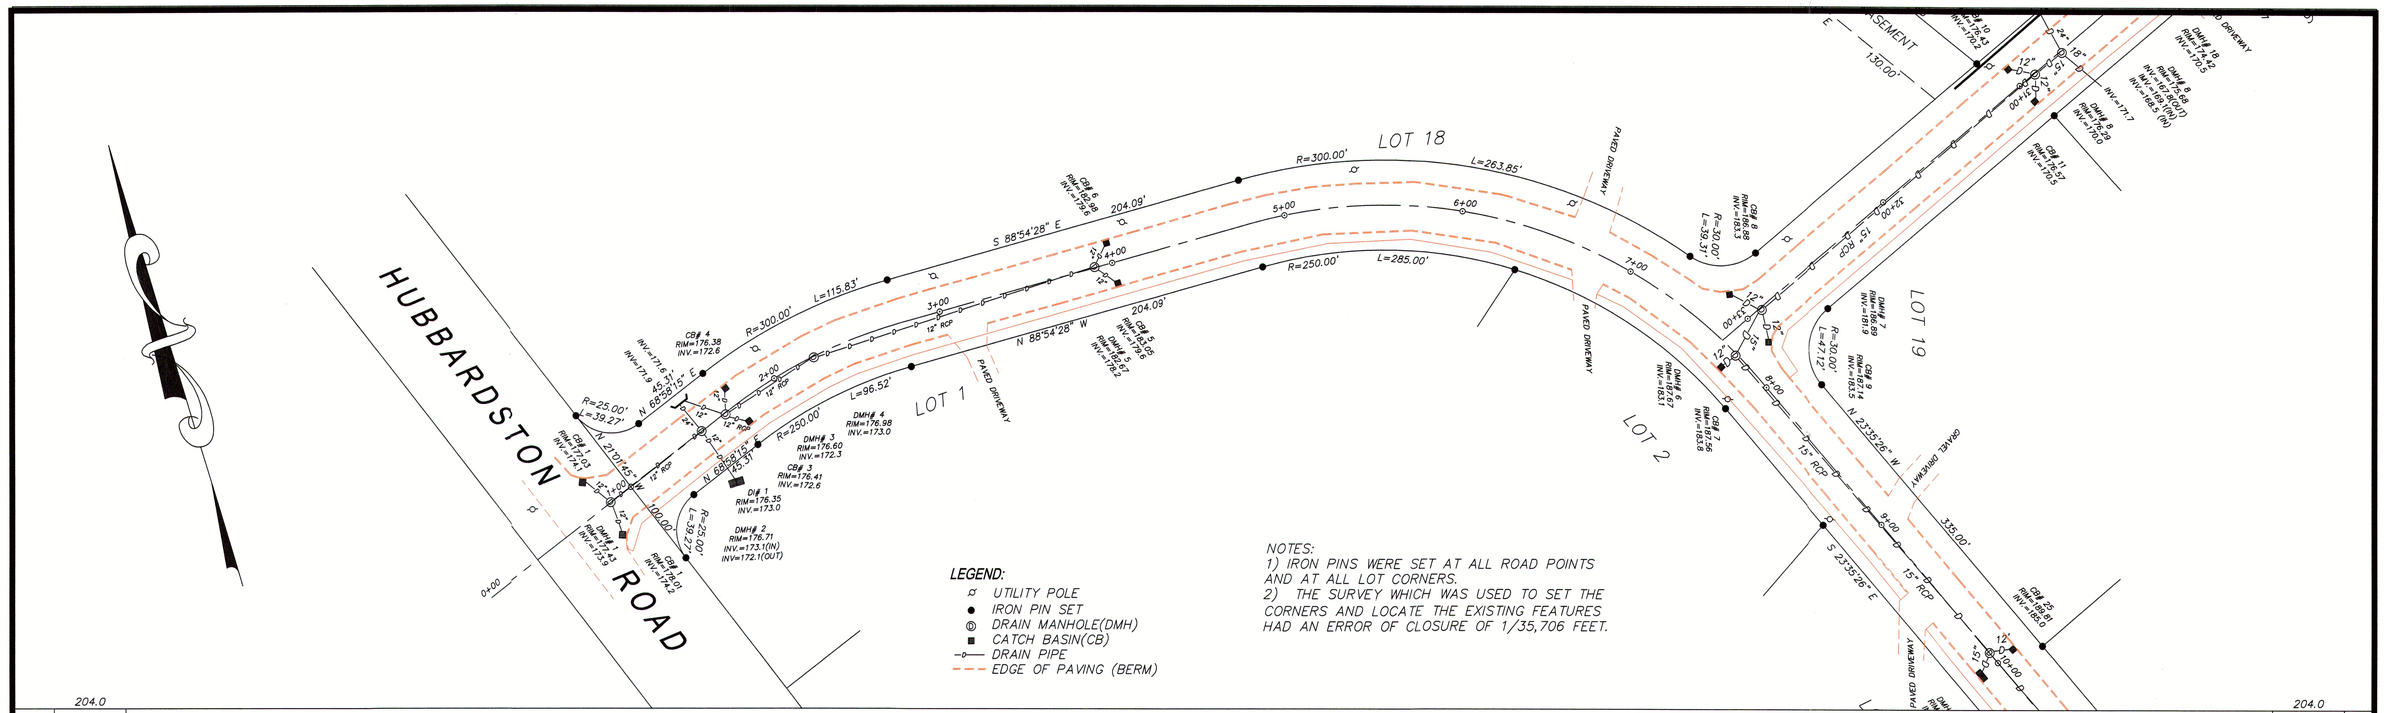

GRAPHIC SCALE

40 0 20 40 80 160

(IN FEET)
1 inch = 40 ft.

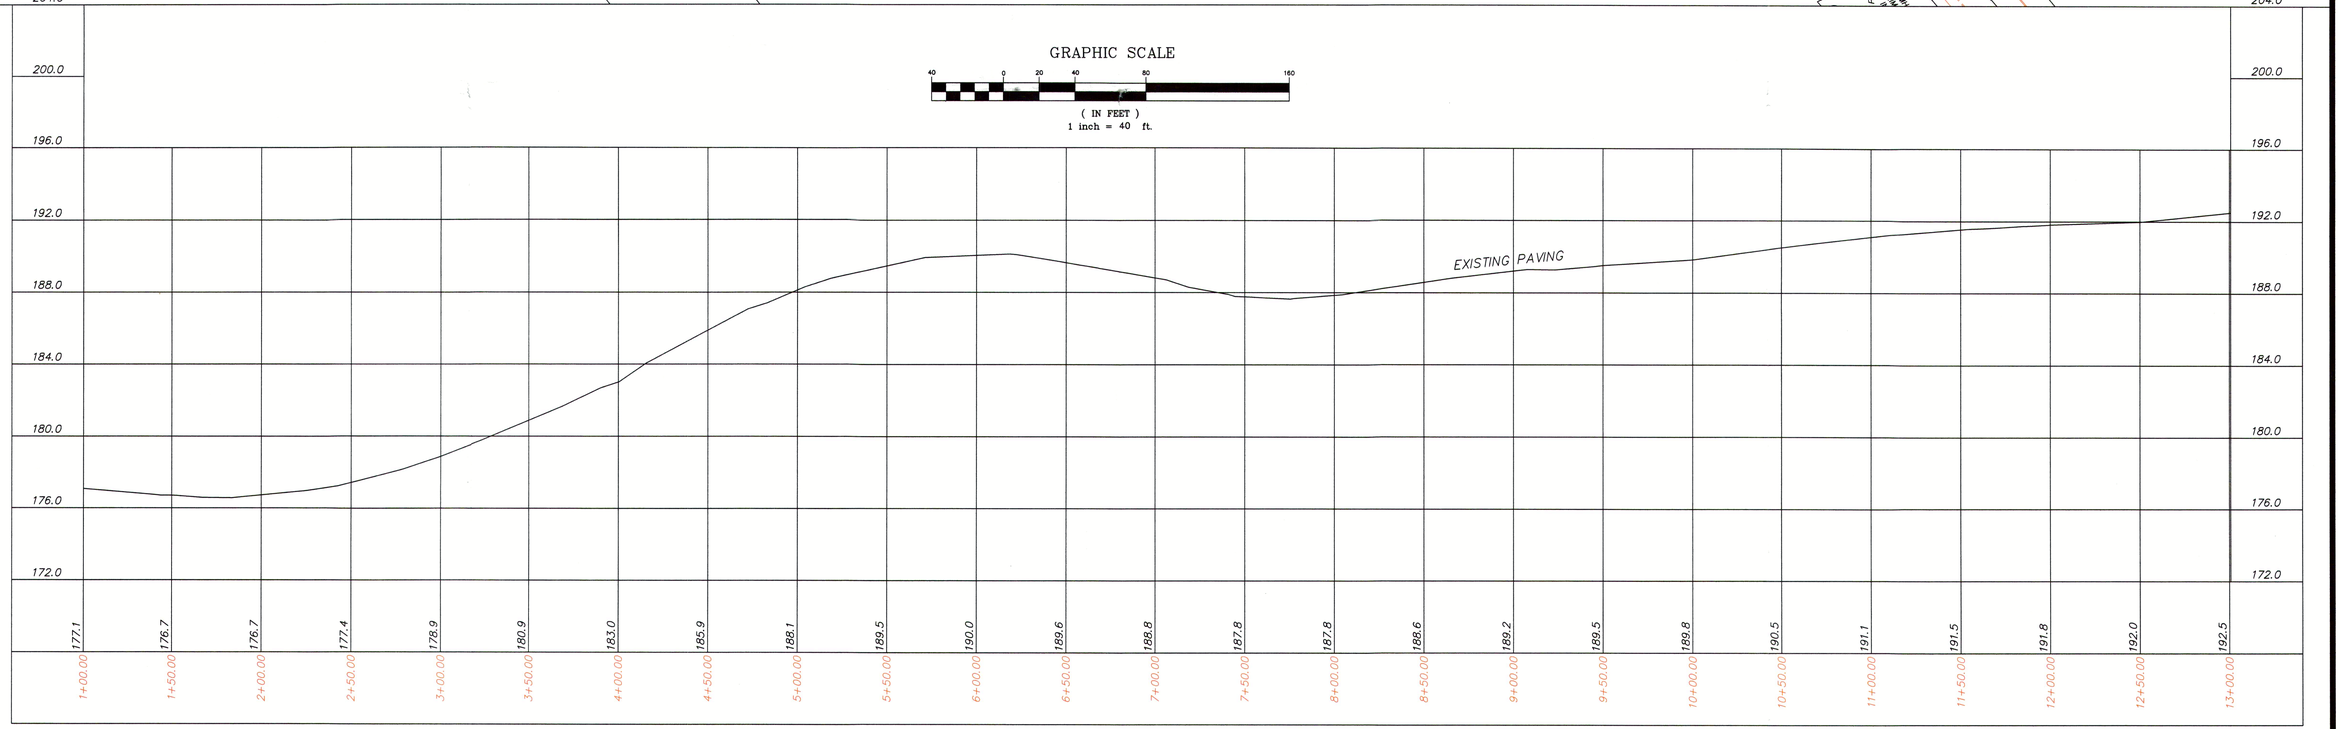

PLAN SCALE:	1"=40'	REVISIONS:			
DATUM:	ASSUMED	No.	Date:	No.	Date:
DRAWN BY:	EJB	1	8-30-04	5	
CALCULATIONS BY:	EJB	2		6	
DRAWN BY:	EJB	3		7	
DATE:	JULY 10, 2004	4		8	

EDMOND J. BOUCHER, PLS
REGISTERED LAND SURVEYOR
4 JOLLY ROAD, ROYALSTON, MA 01368
TEL. (978) 249-6685 FAX (978) 249-4517

COMMONWEALTH OF MASSACHUSETTS
EDMOND J. BOUCHER No. 34300
REGISTERED LAND SURVEYOR

AS-BUILT PLAN
OF
LAUREL VIEW
IN
TEMPLETON, MA